

Knob Creek Lot 16 Sect 2

TRANSYLVANIA COUNTY HEALTH DEPARTMENT 8595-55-3423-000

(Sewage disposal system) Improvements Permit and Certificate of Approval

(Ground Absorption Sewage Disposal System - G.S. Chapter 130, Article 13 C) *Provided That, water intake can be used.*

OWNER-OCCUPANT Spec House BUILDING CONTRACTOR (Knob Creek)
 LOCATION Rt 2 Pisgah Forest
 SUBDIVISION Knob Creek Driv LOT NO. 16 SECT. OR-BLOCK-NO. 2
 SEPTIC TANK CONTRACTOR _____ ADDRESS _____

HOUSE MOBILE HOME BUSINESS
 NO. BEDROOMS 4 NO. BATHROOMS 2 1/2
 GARBAGE DISPOSAL UNIT YES NO
 AUTO. DISHWASHER YES NO
 AUTO. WASH. MACHINE YES NO
 SIZE OF SEPTIC TANK 1100 GALS. (Liquid) Large
 MATERIAL: PRE-CAST BLOCK FIBERGLASS
 DISTRIBUTION BOX YES NO
 NO. OF LINES 3 WIDTH 4 FT. LENGTH 67 FT.
 PERCOLATION TEST YES NO

WATER SUPPLY: INDIVIDUAL PUBLIC
 IMPROVEMENTS PERMIT: DATE: 11-22-76



BY H. S. McDonald

CERTIFICATE OF APPROVAL: DATE: 11-30-76

BY Harold C. McDowell

NOTICE: System installed according to Rules and Regulations but not a guarantee that it will function satisfactorily for any given period of time.

COLOR CODE: White-Owner; Pink-Improvements Permit; Blue-Inspections Dept.; Green-Health Dept.

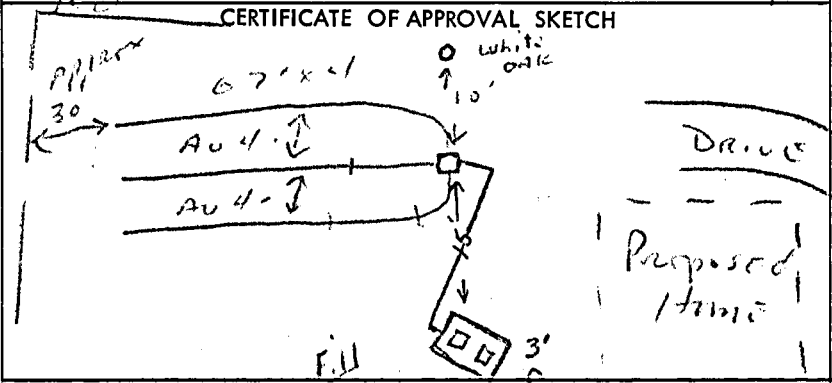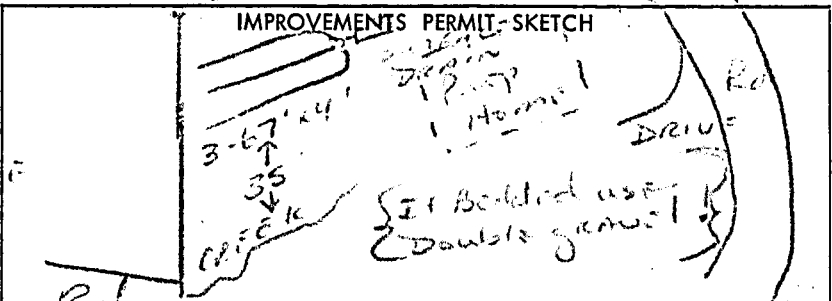

OAK