TRANSYLVANIA COUNTY HEALTH DEPARTMENT

Re-Issued

(Sewage disposal system) Improvements Permit and Certificate of Completion

(Ground Absorption Sewage Disposal System - Section 130 - 160 of Chapter 130 of the General Statutes of North Carolina)

OWNER-OCCUPANT C W. Crumrine BUILDING CONTRACTOR Steve Gentry

LOCATION Chelcadee LANE

SUBDIVISION Wilkee Hills No II LOT NO. 14 SECT. OR BLOCK NO.

SEPTIC TANK CONTRACTOR Burlin McCall ADDRESS

HOUSE ☐ MOBILE HOME ☐ BUSINESS ☐

NO. BEDROOMS 2 NO. BATHROOMS 2

SIZE OF SEPTIC TANK 855 GALS. (Liquid)

MATERIAL: PRE-CAST ☒ BLOCK ☐ FIBERGLASS ☐

DISTRIBUTION BOX YES ☒ NO ☐

NO. OF LINES 2 See Original WIDTH 3' FT. LENGTH 74 FT.

PERCOLATION TEST 1-12-79 YES ☐ NO ☒

WATER SUPPLY: INDIVIDUAL ☒ PUBLIC ☐

SITE CLASSIFICATION: SUITABLE ☐

PROV. SUITABLE ☐

UNSUITABLE ☐

IMPROVEMENTS PERMIT: DATE: 1-9-79

BY


CERTIFICATE OF COMPLETION: DATE: 1-12-79

BY

NOTICE: System installed according to Rules and Regulations but not a guarantee that it will function satisfactorily for any given period of time.

COLOR CODE: White - Owner; Pink - Improvements Permit; Blue - Contractor; Yellow - Inspection Dept.; Green - Health Dept.

IMPROVEMENTS PERMIT SKETCH

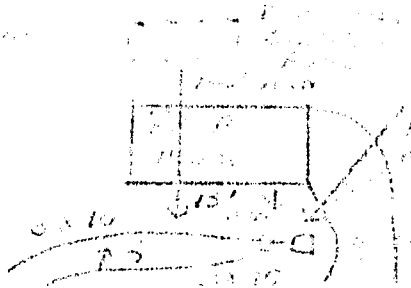

CERTIFICATE OF COMPLETION SKETCH

